
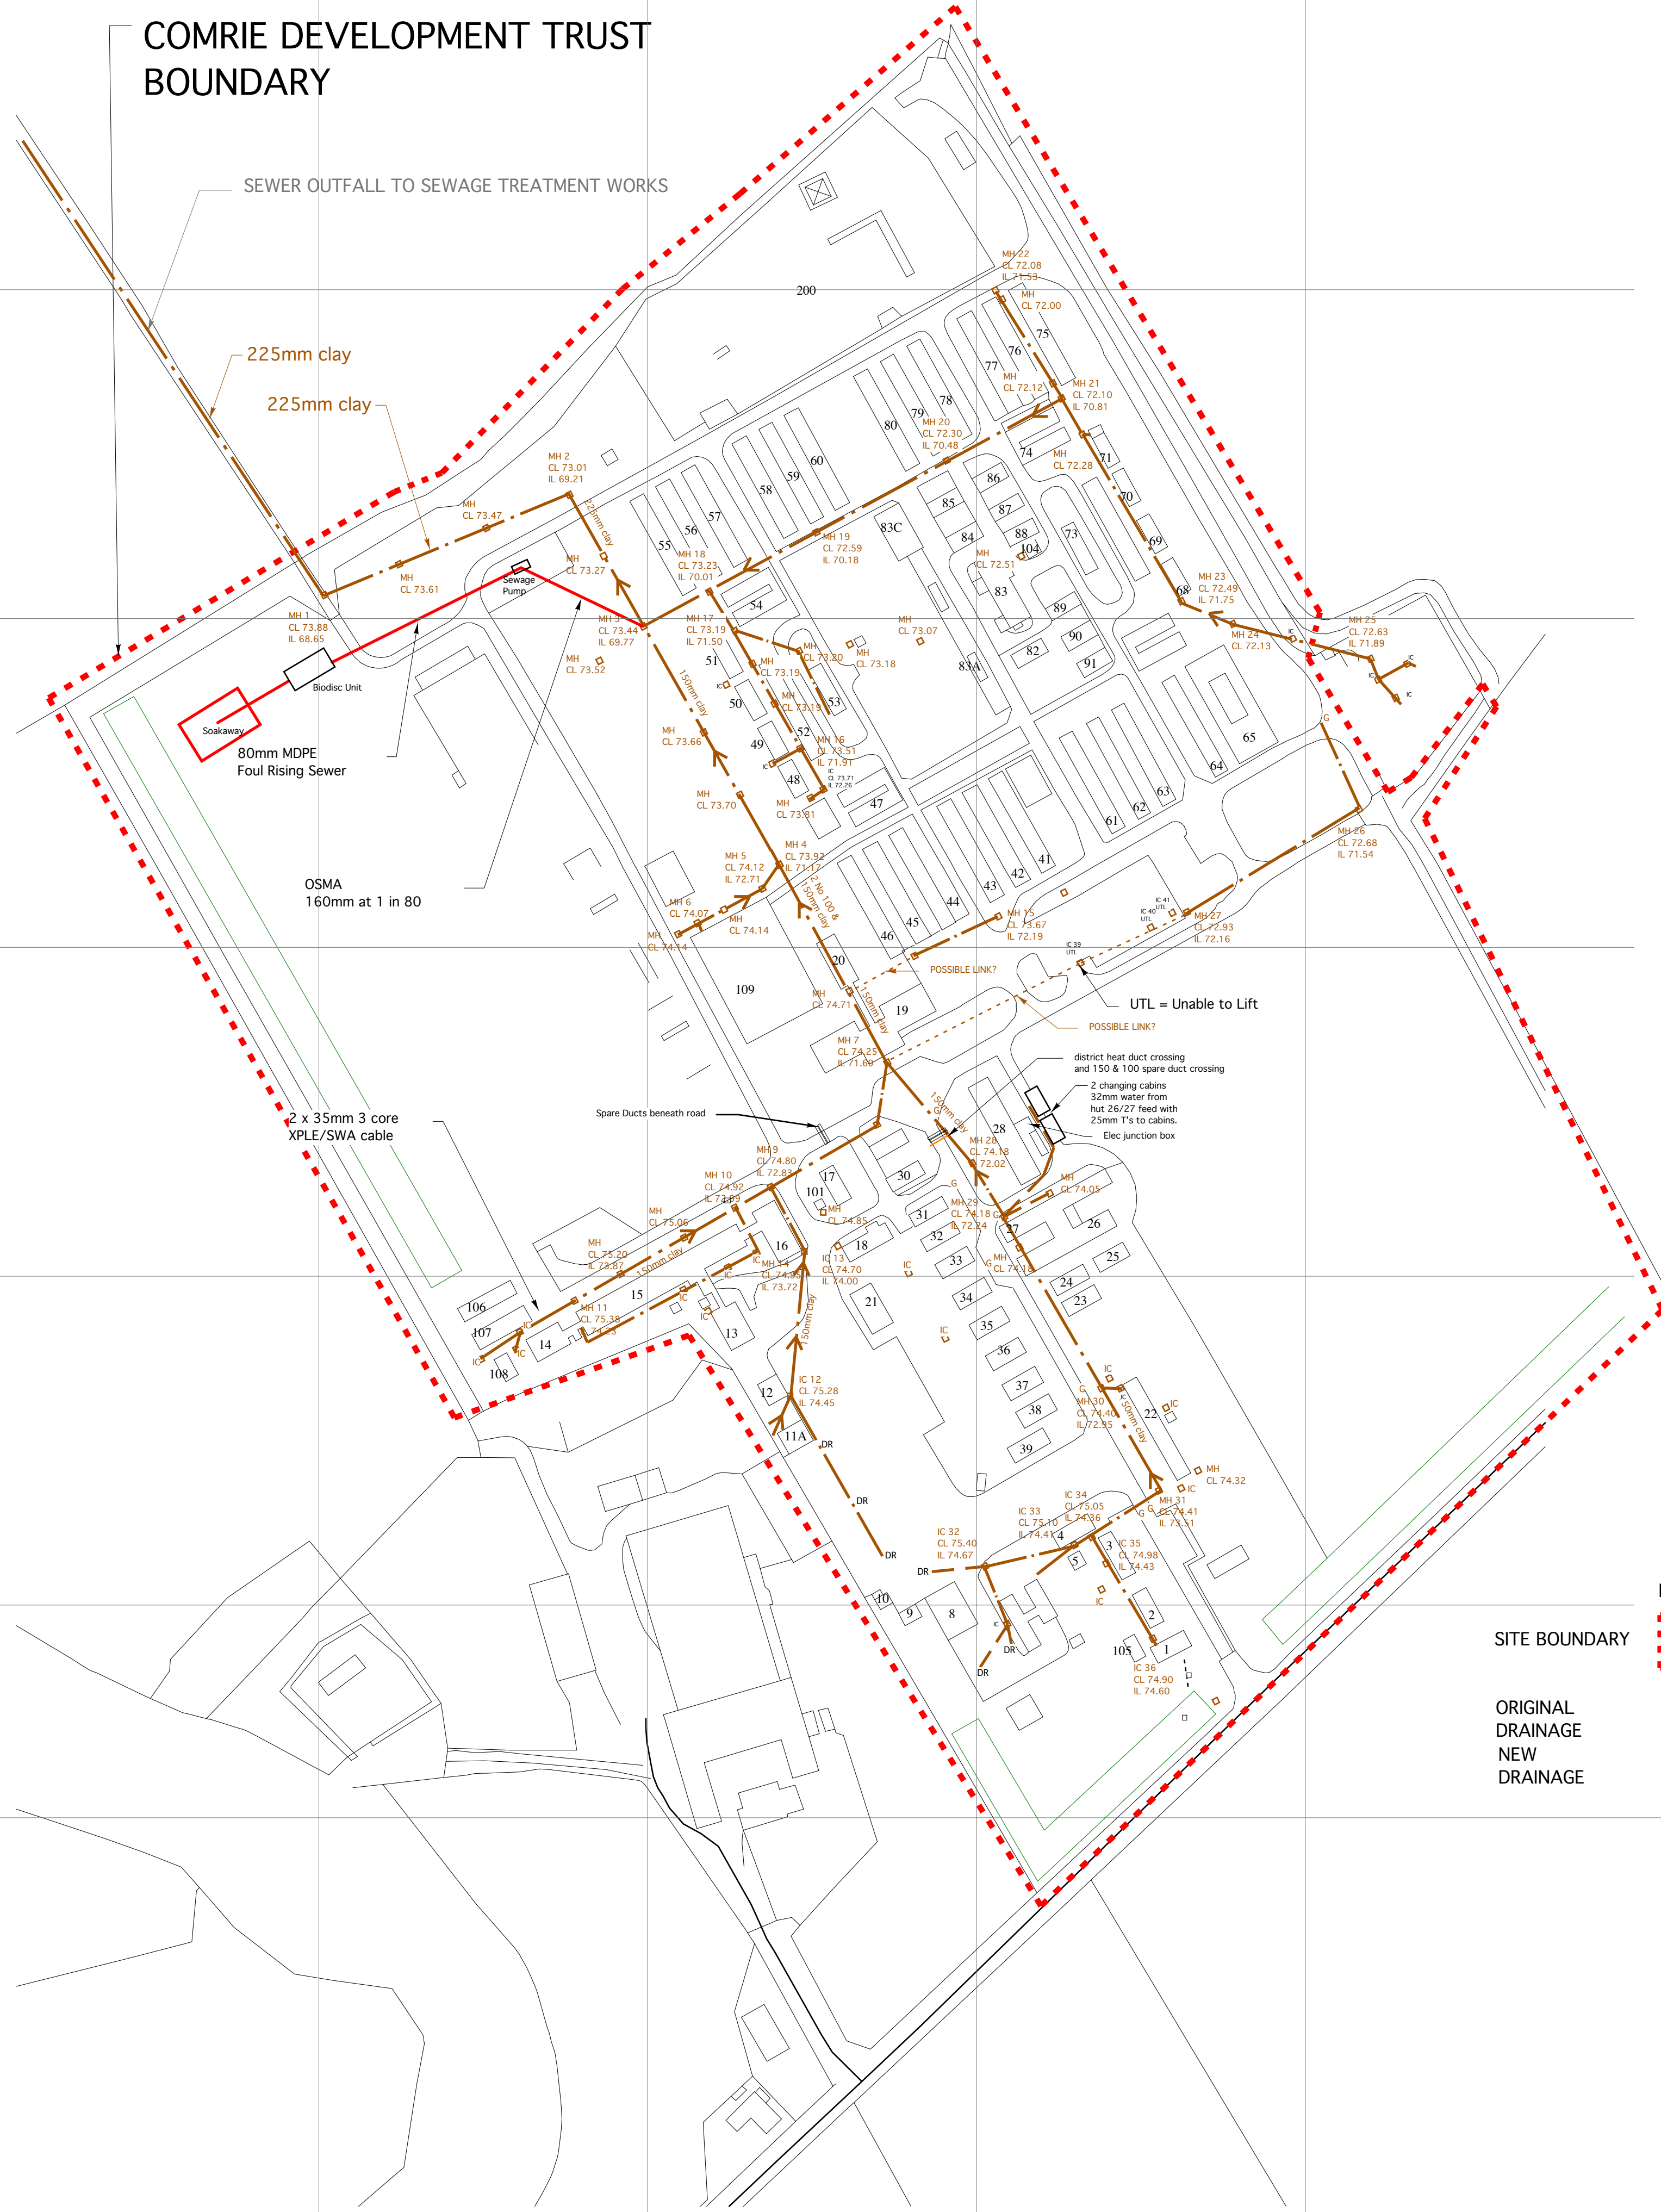


NORTH

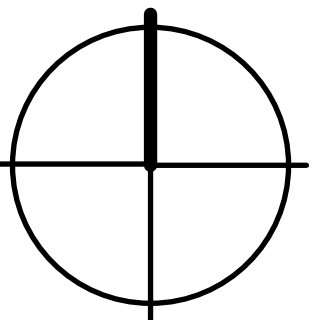

0m 10m 100m

PLEASE NOTE: ORIGINAL SERVICES INFORMATION INCLUDING MANHOLE COVER LEVELS AND INVERT LEVELS HAS BEEN TAKEN FROM A SURVEY DRAWING ML/5 PREPARED FOR THE MOD BY MASON SURVEYS DATED 1.12.1995 AND MAY NOT BE ACCURATE OR FULLY REFLECT THE CURRENT SITUATION.

COMRIE DEVELOPMENT TRUST  
CULTYBRAGGAN CAMP  
DRAINAGE PLAN (UPGRADED)

DRAWING No. CDT/CULTY/DRAINS 001

SCALE 1:1250 AT A1

STATUS OF DRAWING: AS BUILT RECORD (FEB 15)

