



NORTH

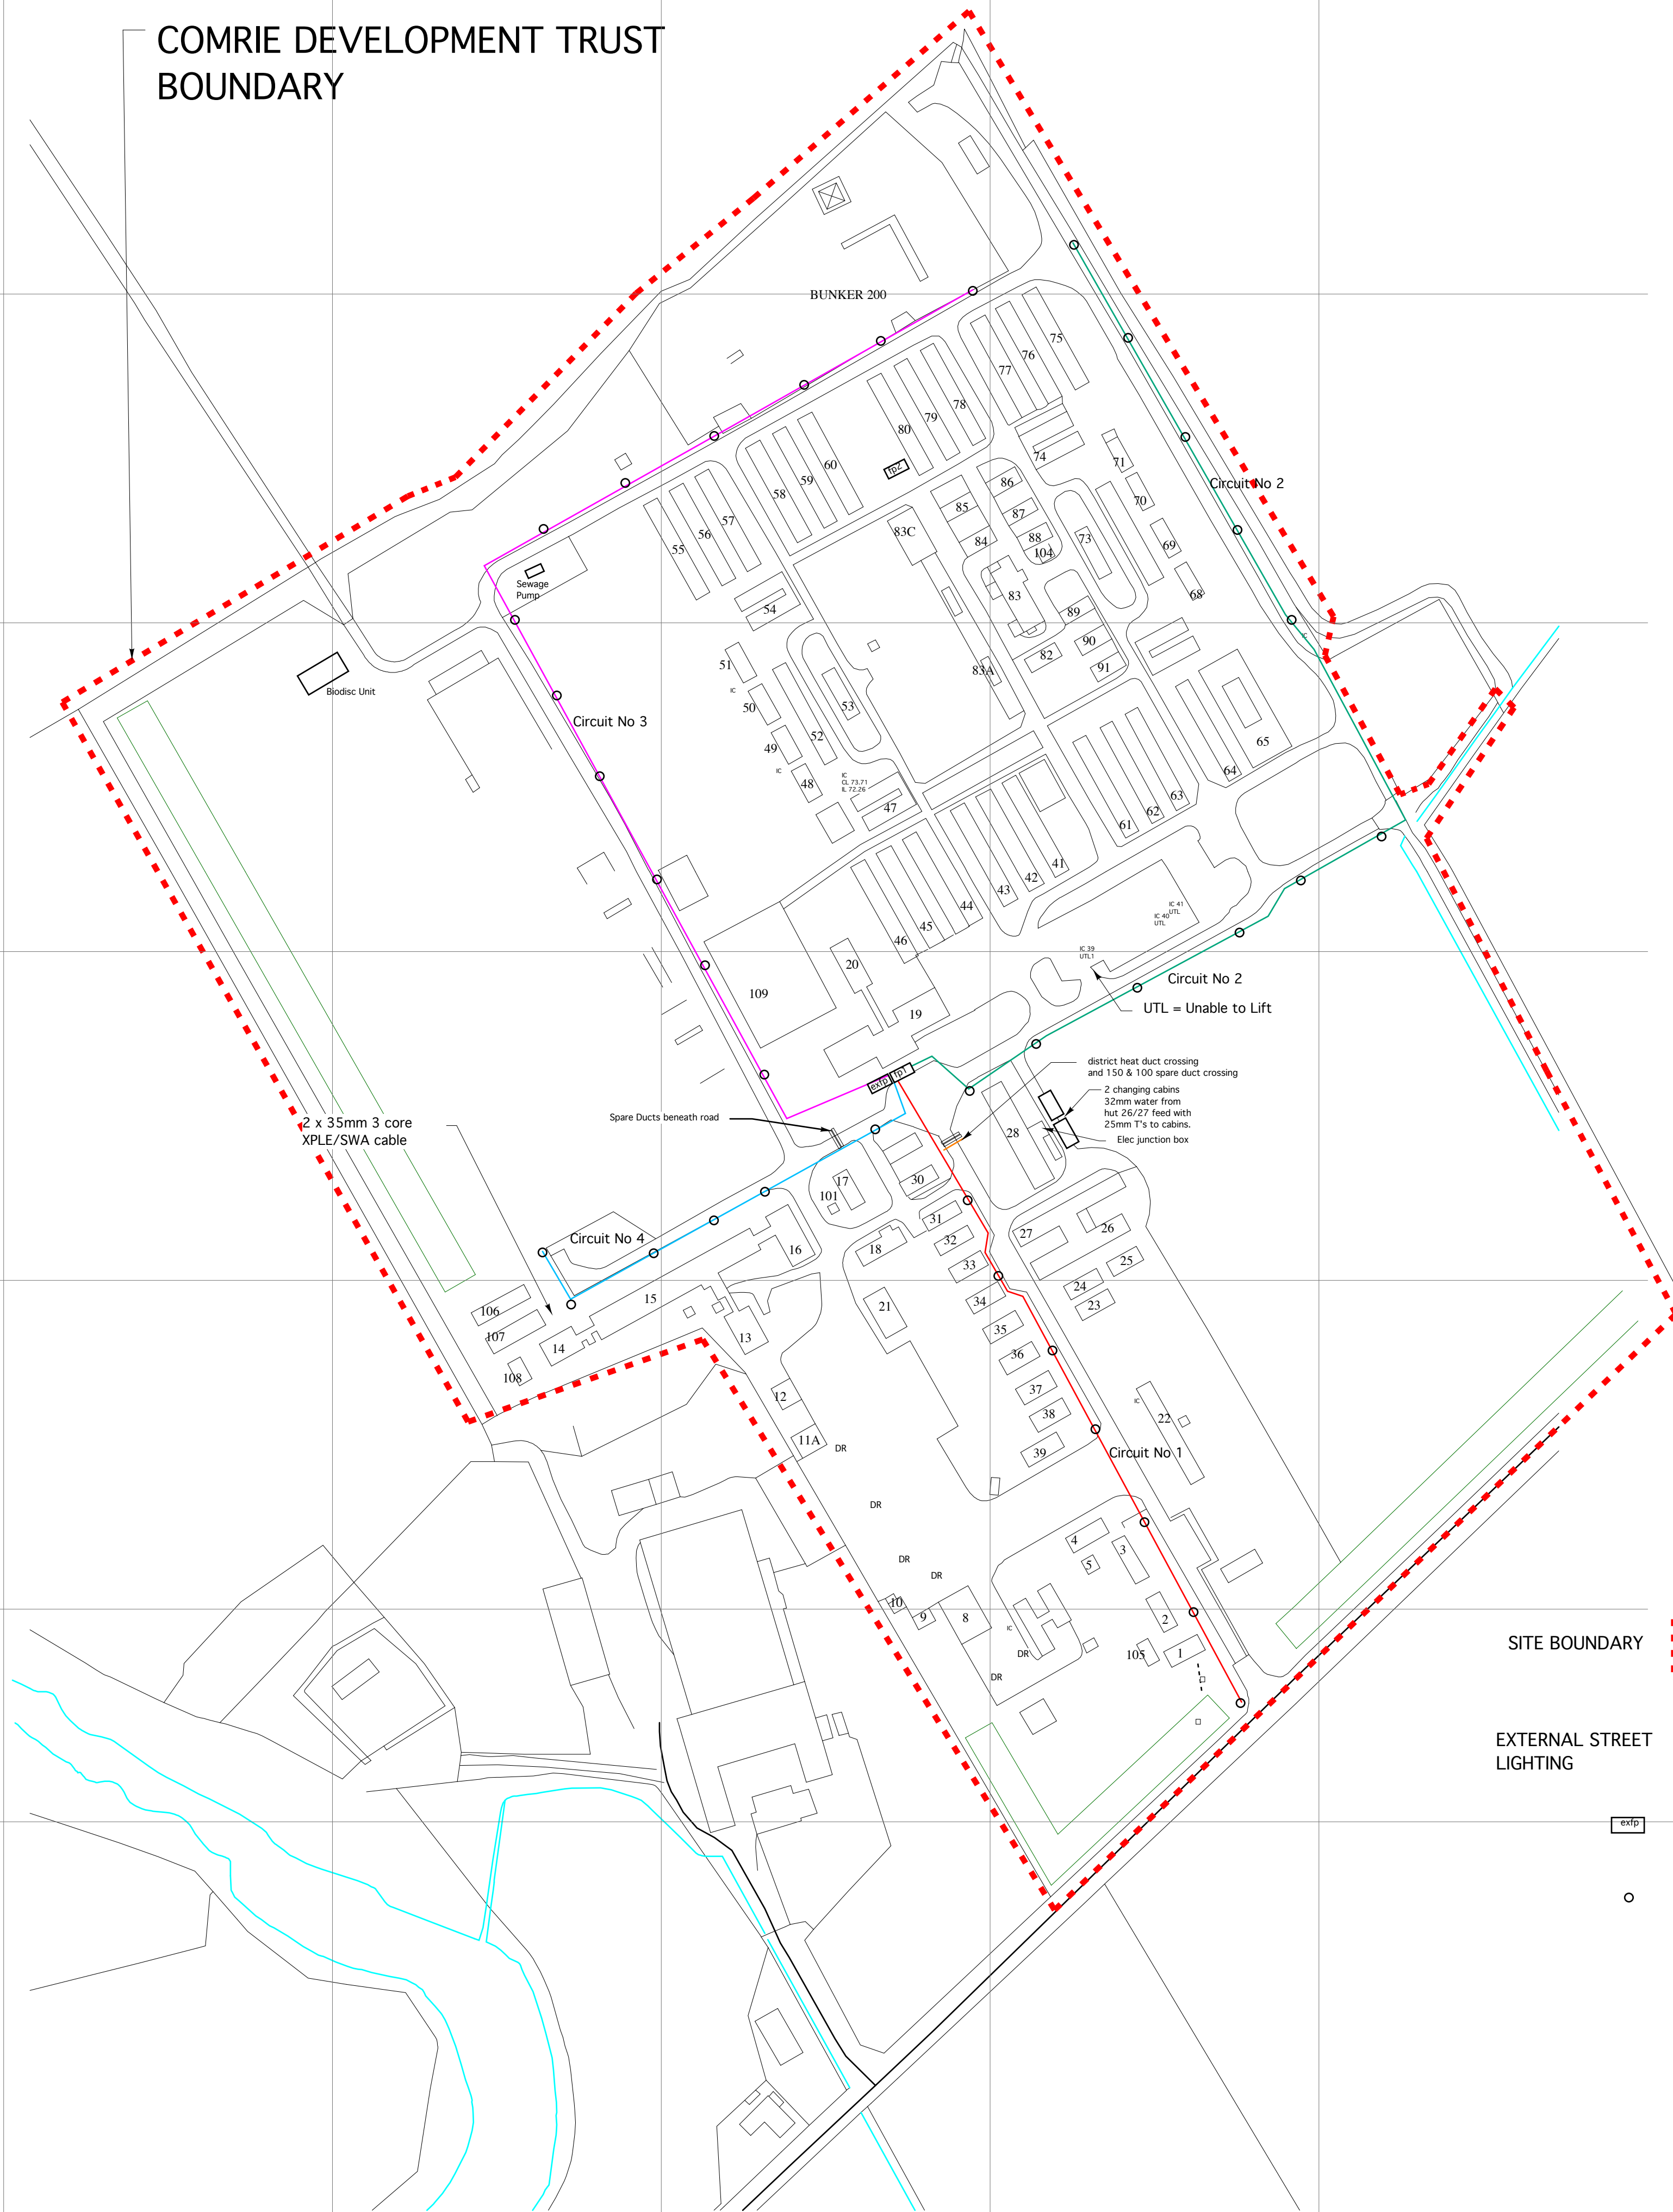

KEY

SITE BOUNDARY

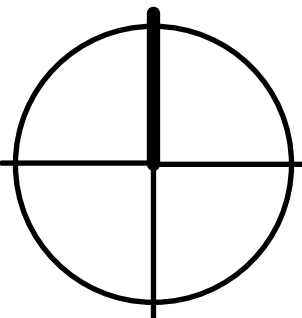

EXTERNAL STREET LIGHTING

- Circuit No 1 6mm 3 core
- Circuit No 2 10mm 3 core
- Circuit No 3 10mm 3 core
- Circuit No 4 6mm 3 core



Electrical external feeder pillar
(Lighting controlled by timelock
and photo-cell at external feeder pillar)



5M Galv column c/w street lighting
head 70 watt SON

PLEASE NOTE: ORIGINAL SERVICES INFORMATION INCLUDING MANHOLE COVER LEVELS AND INVERT LEVELS HAS BEEN TAKEN FROM A SURVEY DRAWING ML/5 PREPARED FOR THE MOD BY MASON SURVEYS DATED 1.12.1995 AND MAY NOT BE ACCURATE OR FULLY REFLECT THE CURRENT SITUATION.

COMRIE DEVELOPMENT TRUST
CULTYBRAGGAN CAMP
STREET LIGHTING SERVICES PLAN (UPGRADED)

DRAWING No. CDT/CULTY/LIGHTING 001

SCALE 1:1250 AT A1

STATUS OF DRAWING: AS BUILT RECORD FEB 15

